




G:\TX\H\Projects\Kinder_Morgan\5750-05_Guadalupe_River_Project\GIS\Wetland\Exhibits\Ex1a_Vicinity_4in_20180806.mxd

BGE
 BGE, Inc.
 10777 Westheimer, Suite 400, Houston TX 77042
 Tel: 281-558-8700 Fax: 281-558-9701
 www.bgeinc.com

Vicinity Map
 Copano Mission Valley / Guadalupe River
 Abandonment (4-inch)
 Aquatic Resource Delineation
 Victoria County, Texas

Date: August 2018 Proj. No: 5750-05 Exhibit No: 1

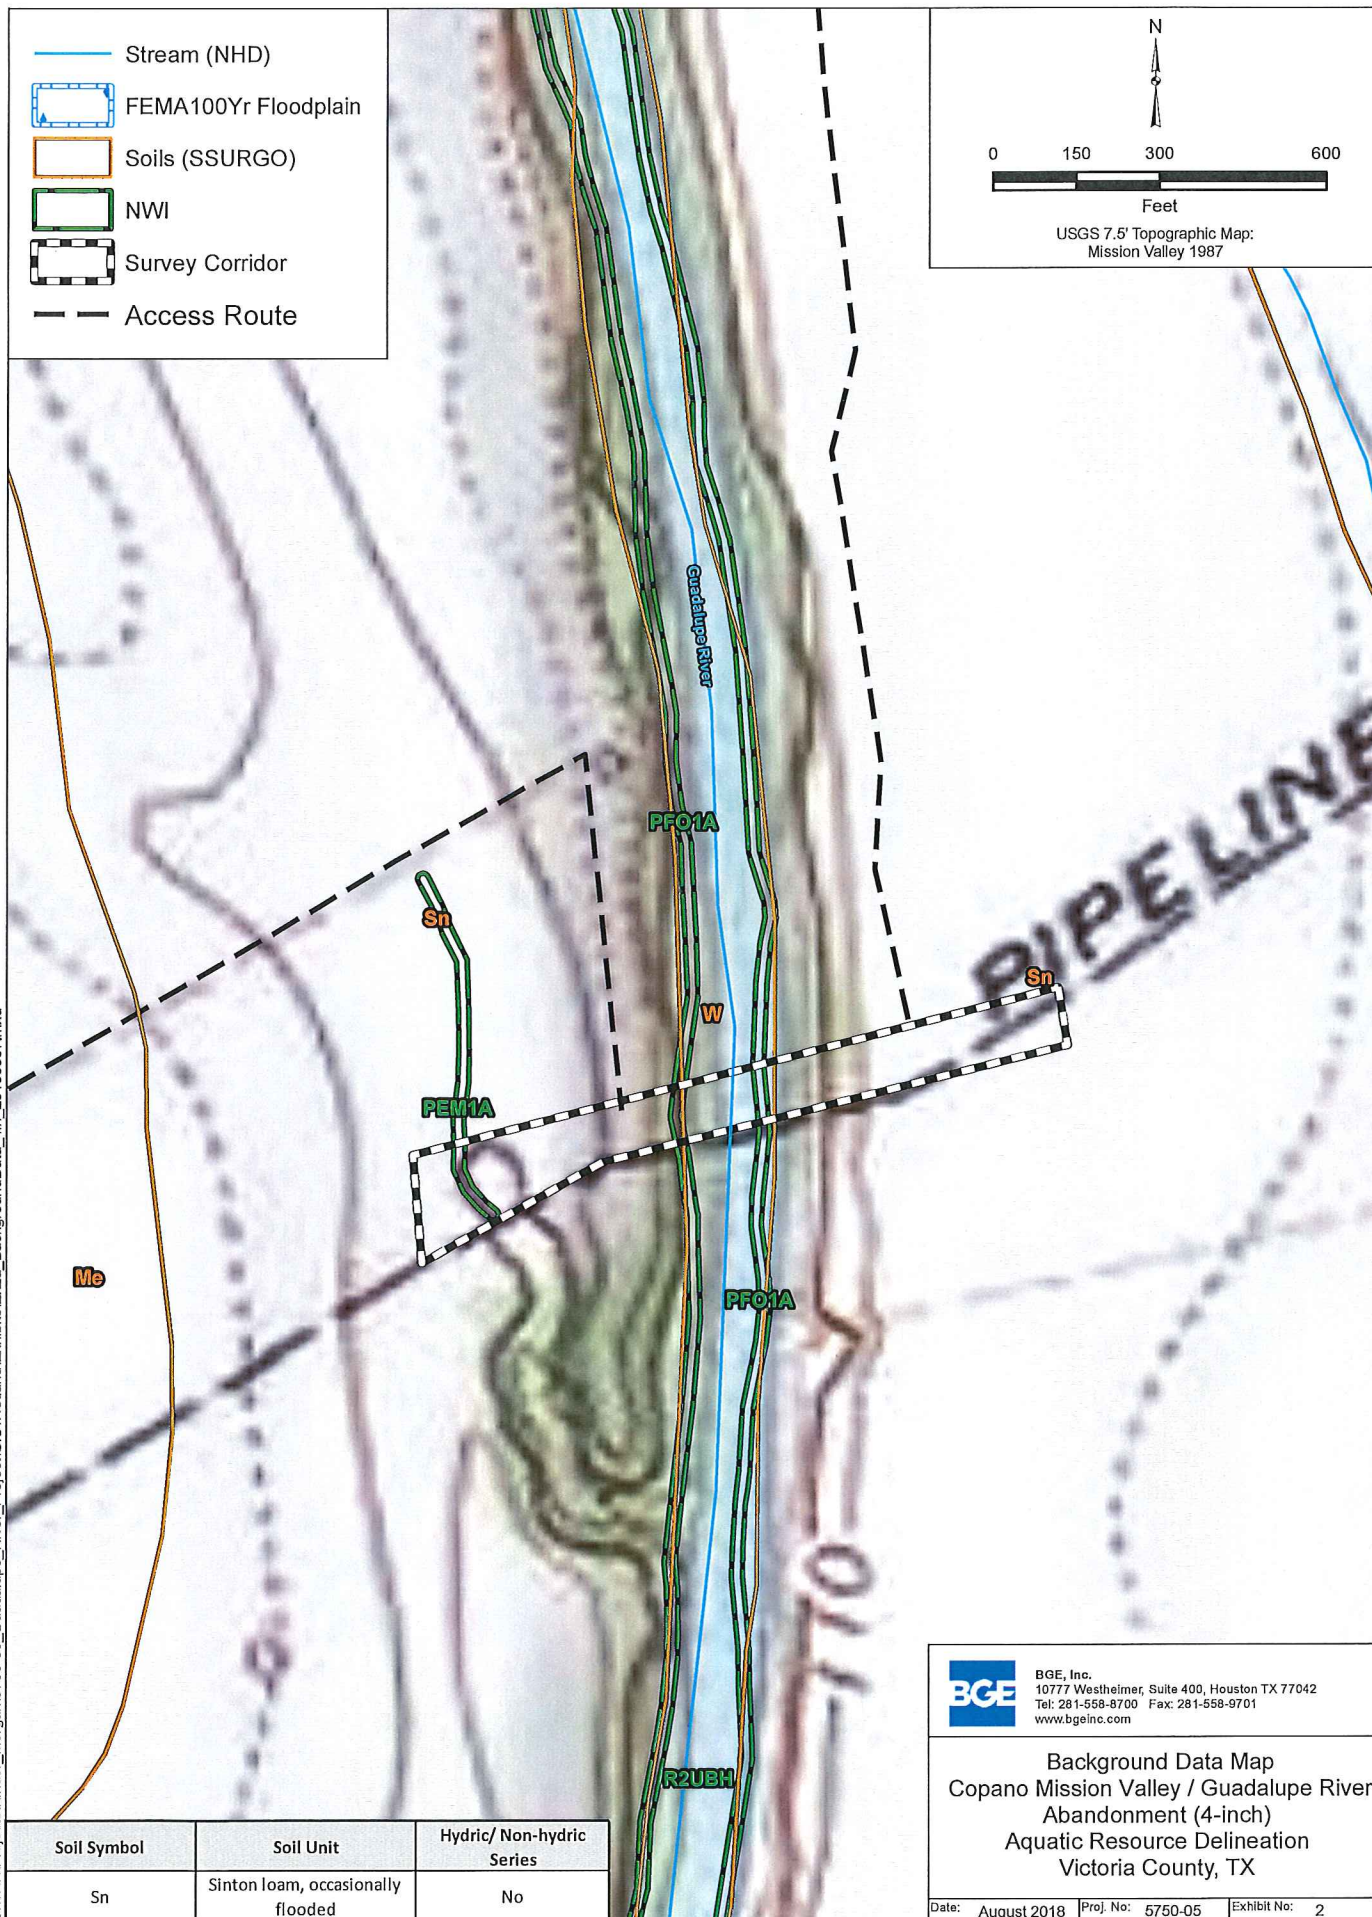

G:\TX\H\Projects\Kinder_Morgan\5750-05_Guadalupe_River_Project\GIS\Wetland\Exhibits\Ex2a_BackgroundData_4in_20180807.mxd

Soil Symbol	Soil Unit	Hydric/ Non-hydric Series
Sn	Sinton loam, occasionally flooded	No

BGE, Inc.
 10777 Westheimer, Suite 400, Houston TX 77042
 Tel: 281-558-8700 Fax: 281-558-9701
www.bgeinc.com


Background Data Map
 Copano Mission Valley / Guadalupe River
 Abandonment (4-inch)
 Aquatic Resource Delineation
 Victoria County, TX

Date: August 2018	Proj. No: 5750-05	Exhibit No: 2	
-------------------	-------------------	---------------	--




G:\TX\H\Projects\Kinder_Morgan\5750-05_Guadalupe_River_Project\GIS\Wetland\Exhibits\Ex3a_FieldData_4in_20180807.mxd

SEP 28 2018

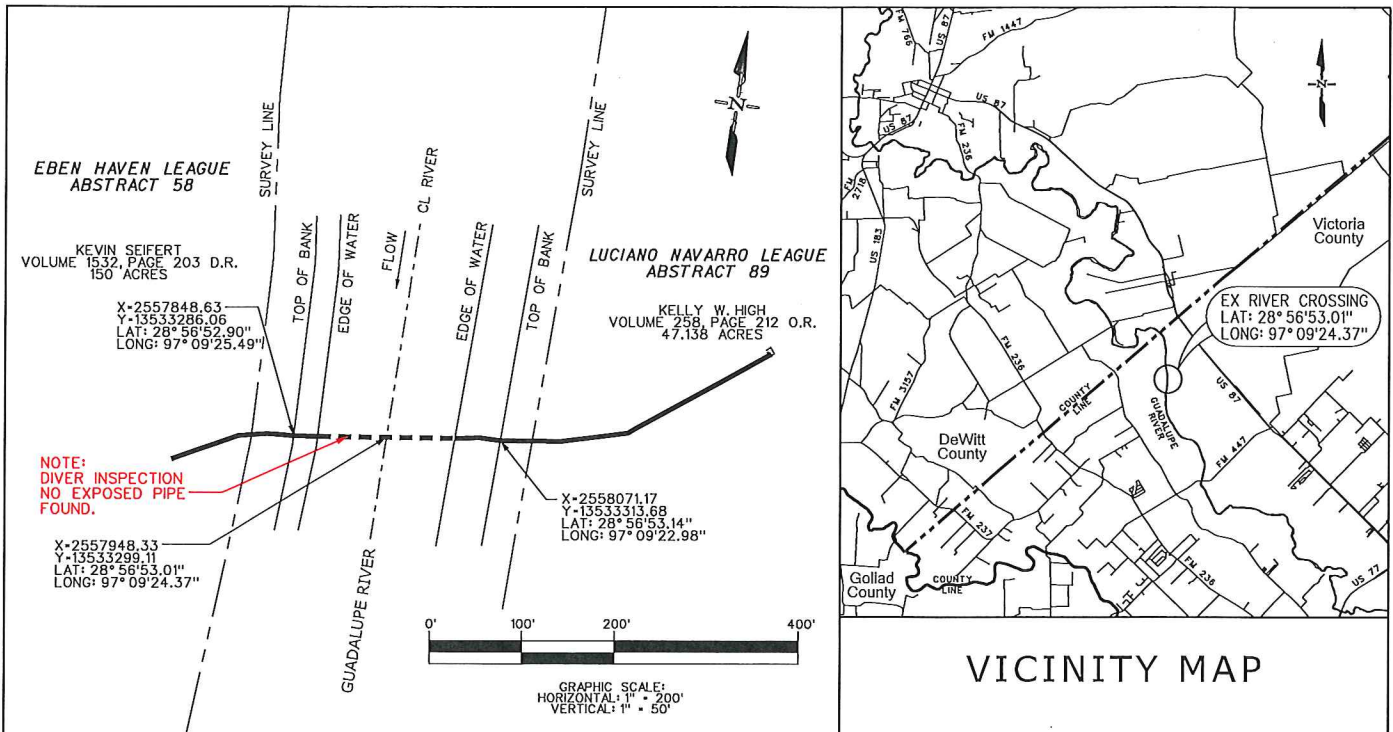

UNABLE TO LOCATE PIPELINE DEPTH
IN RIVER BED DUE TO ROCKY SUBSTRATE

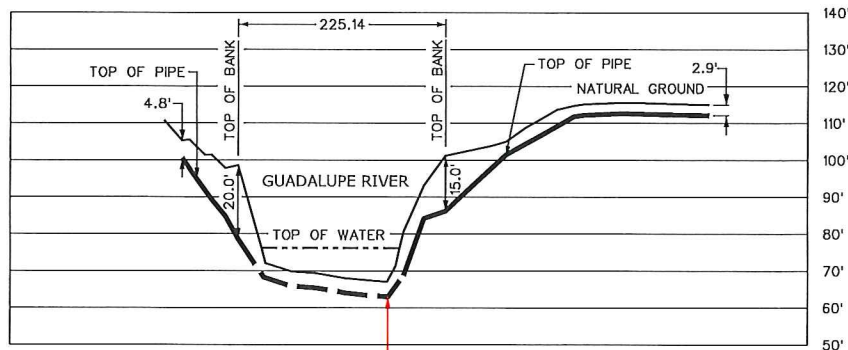

PIPE DATA:
4.500" OD
PRODUCT = NATURAL GAS

COORDINATES BASED ON TEXAS COORDINATE SYSTEM
HORIZONTAL: NAD 83 SOUTH CENTRAL ZONE
VERTICAL: NGVD 1988

	DRAWN BY	G&K/GKS	09-05-18	KINDER MORGAN COPANO ENERGY, L.L.C. 1001 LOUISIANA STREET, SUITE 1000 HOUSTON, TEXAS 77002 GUADALUPE RIVER CROSSING AS-BUILT 4" NATURAL GAS PIPELINE VICTORIA COUNTY, TEXAS FIRM NO. F-9183 SHEET NO. 1
	SCALE:	1" = 200'		
	JOB NO:	PC18-121		
	REVISION:			
	PREPARED BY:	G.K.S.		
	GANEM & KELLY SURVEYING, INC. LAMAR STREET, SUITE 5 POINT COMFORT, TEXAS 77978 (361) 987-2011 FIRM NO. 10080300			