
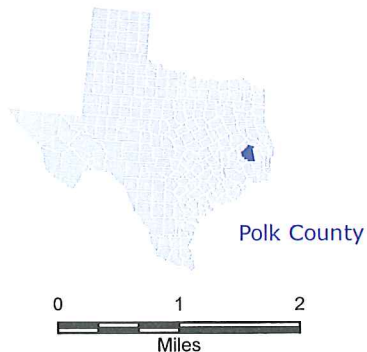


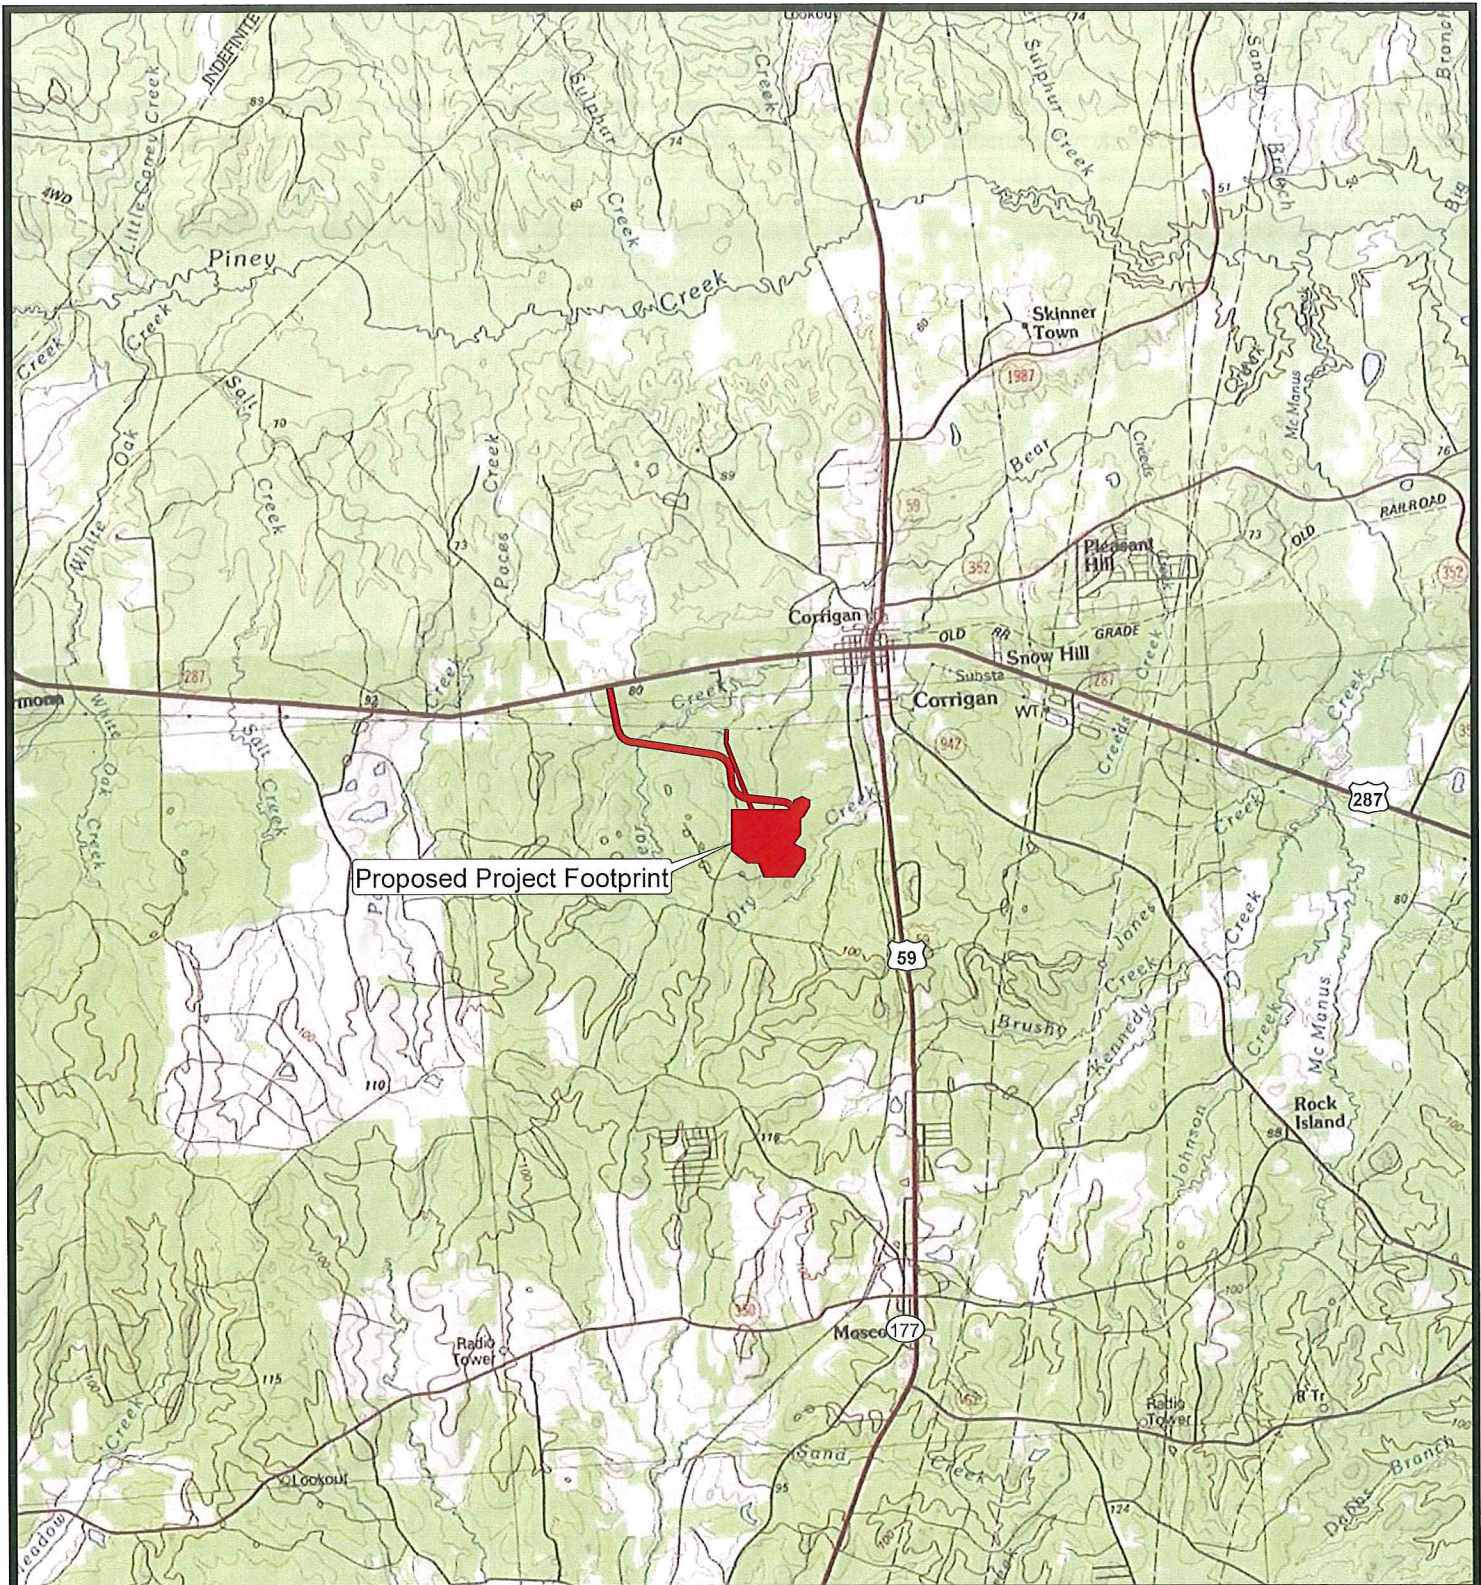

Corrigan OSB, L.L.C.
Corrigan, Texas

Department of the Army Permitting

Site Location Map


Polk County



Drawn:	CPL/AM10.4
Checked:	WLB
Approved:	TEW
Date:	08/04/2016
Dwg. No.:	A12356-40

Figure 1

Proposed Project Footprint (284 acres)
Waters of the US within Proposed Project Footprint

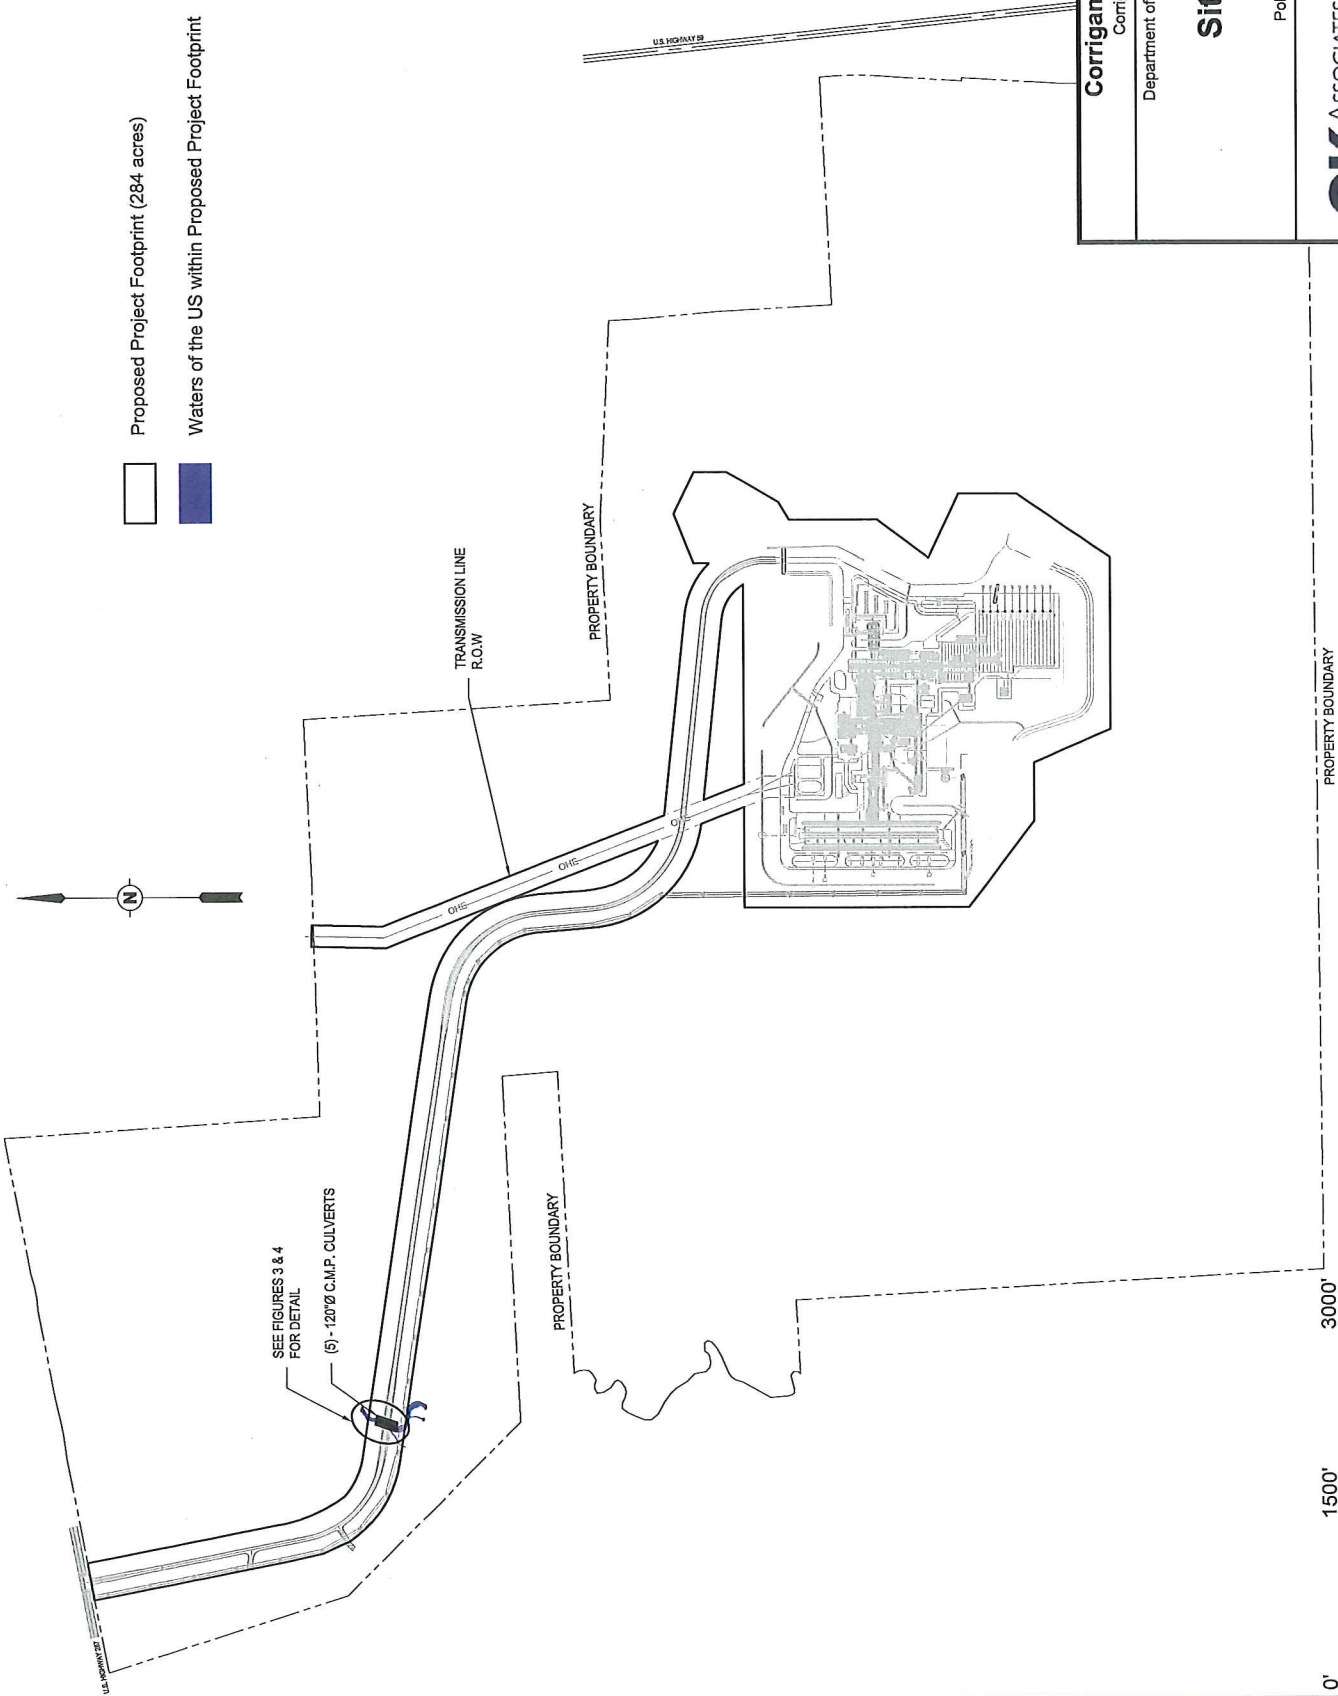

Corrigan OSB, L.L.C.
Corrigan, Texas

Department of the Army Permitting

Site Plan

Polk County




Drawn: CPL/JACAD
Checked: WLB
Approved: TEW
Date: 08/17/2016
Dwg. No.: A12356-41

Figure 2

0' 1500' 3000'

SCALE: 1" = 1500'

Drawing from Johnson & Pace Inc.

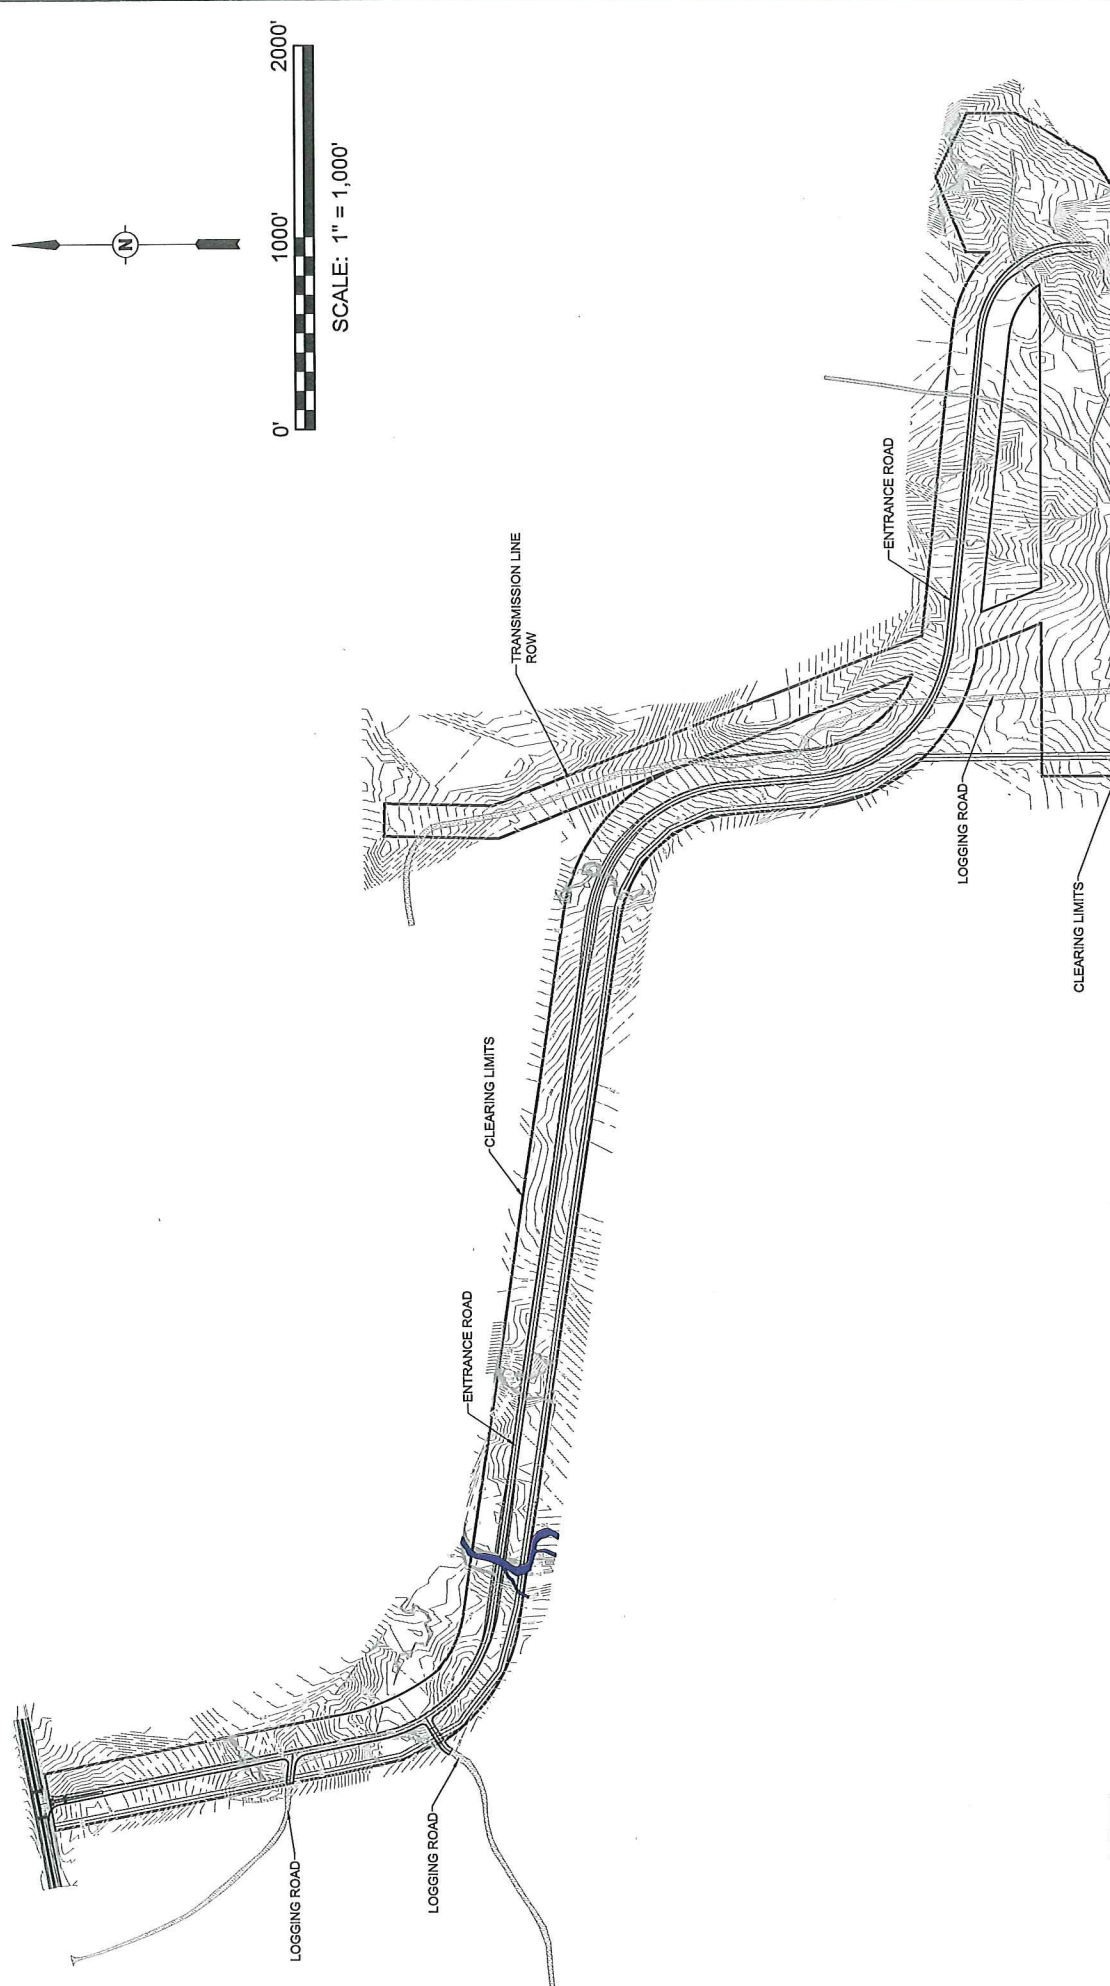

Proposed Project Footprint (284 acres)

Waters of the US within Proposed Project Footprint

Corrigan OSB, L.L.C.

Corrigan, Texas

Department of the Army Permitting


Existing Conditions Entrance Road

Polk County

Drawn:	CPL/JACAD
Checked:	WLB
Approved:	TEW
Date:	08/22/2016
Dwg. No.:	A12356-42



Figure 2A

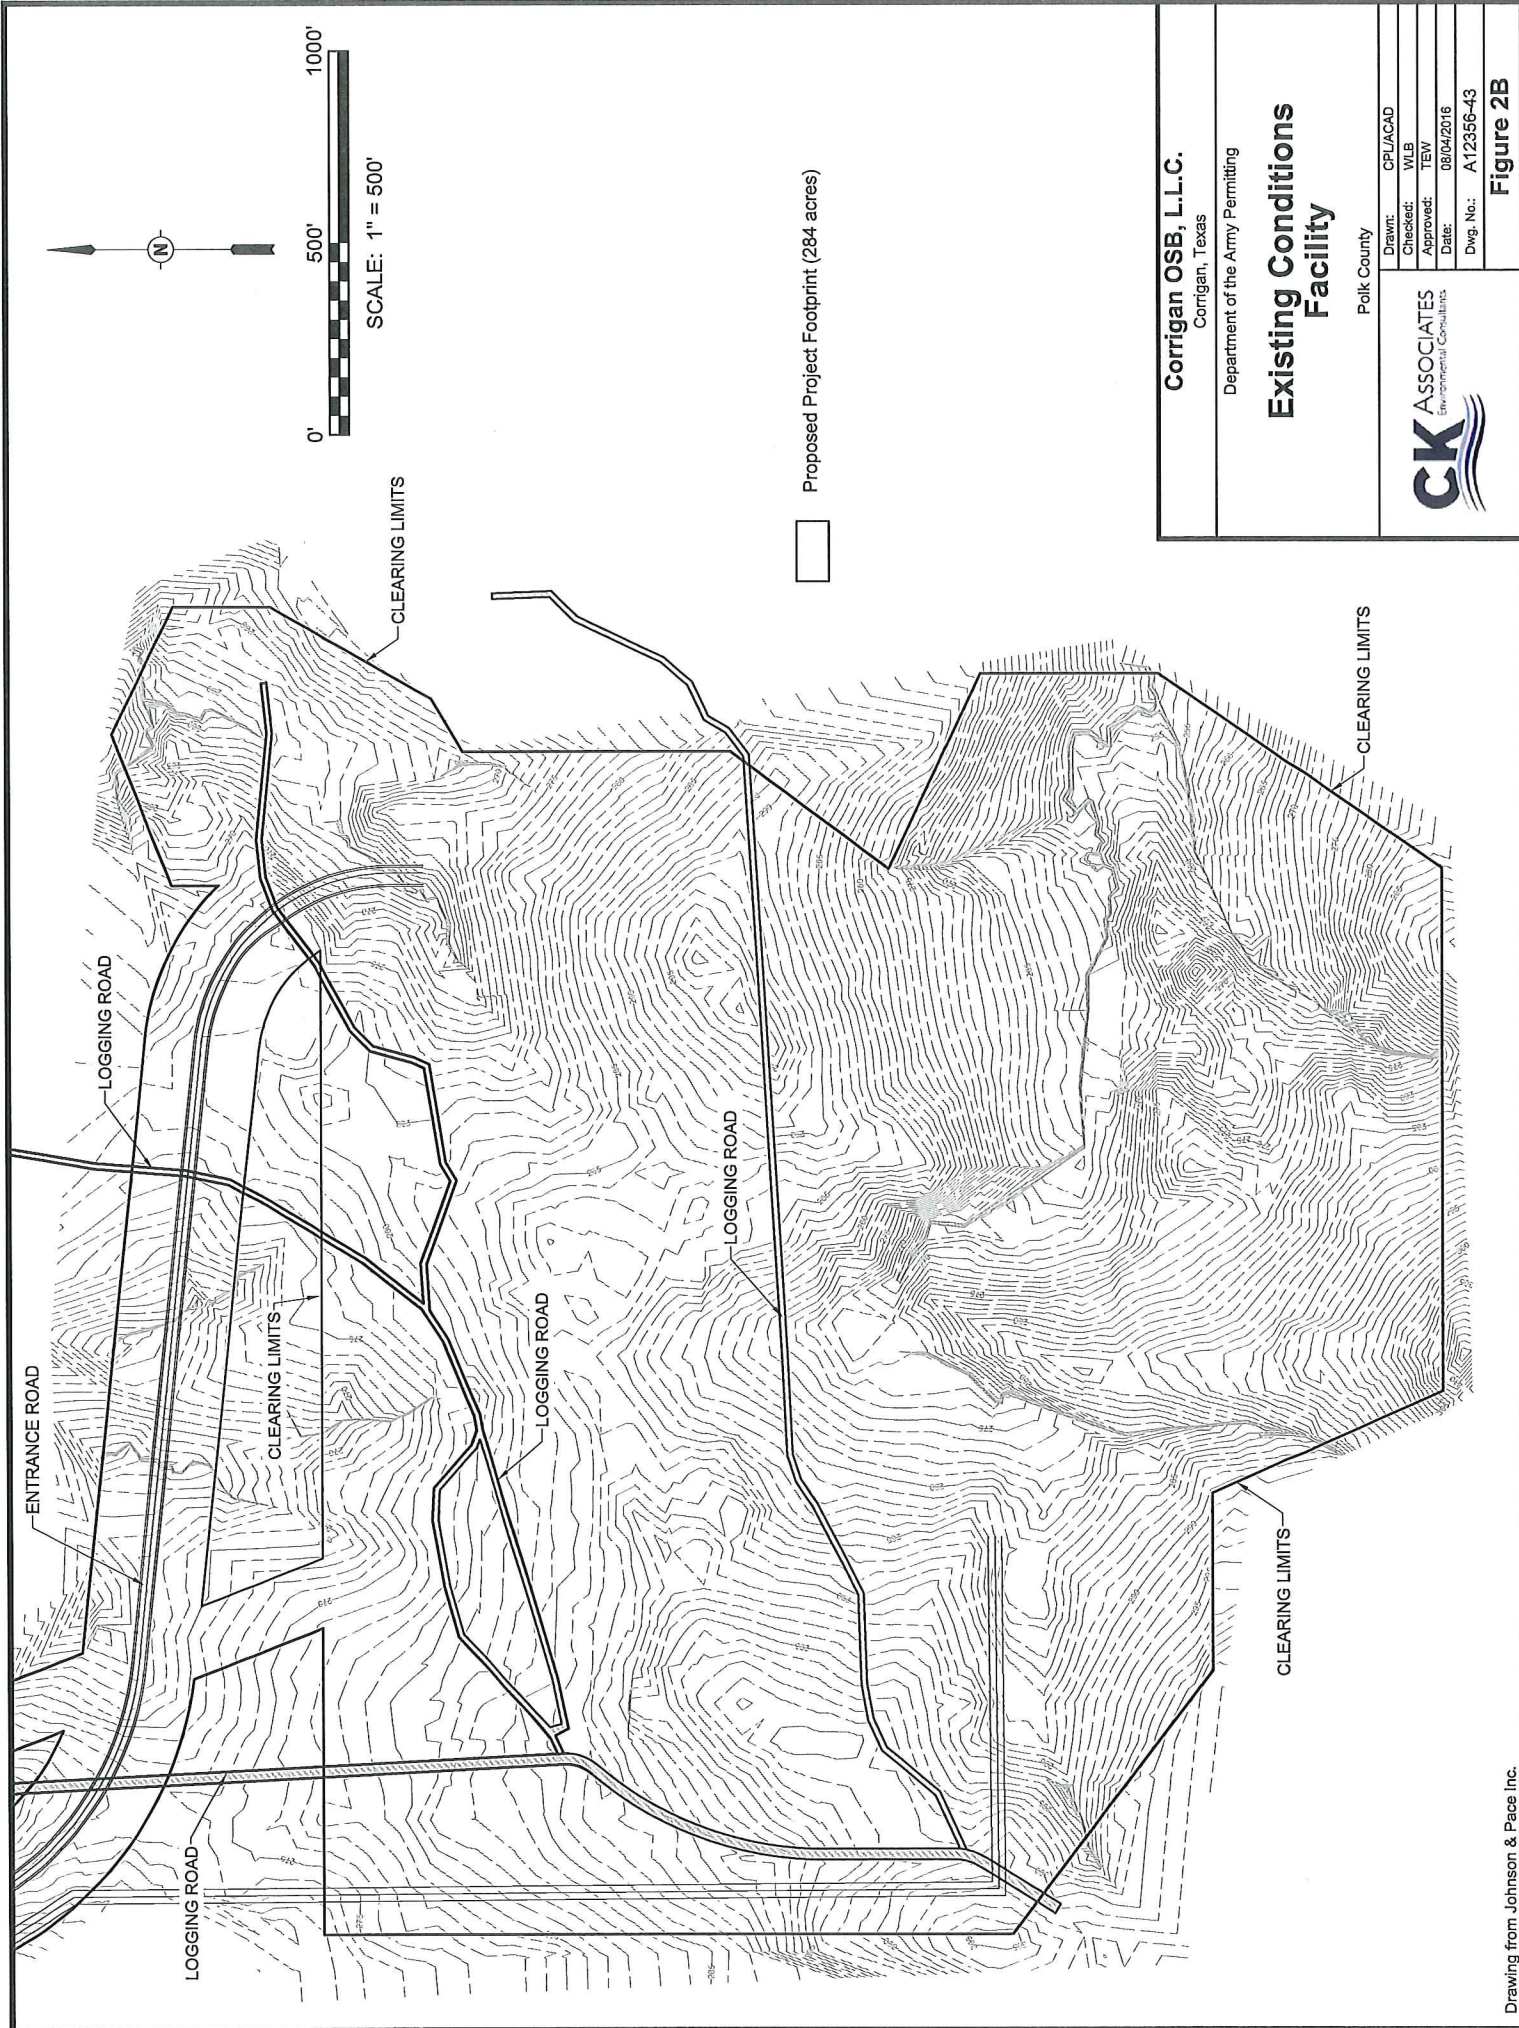

Corrigan OSB, L.L.C.

Corrigan, Texas

Department of the Army Permitting


Existing Conditions Facility

Polk County

Drawn:	CPL/ACAD
Checked:	WLB
Approved:	TEW
Date:	08/04/2016
Dwg. No.:	A12356-43

Figure 2B



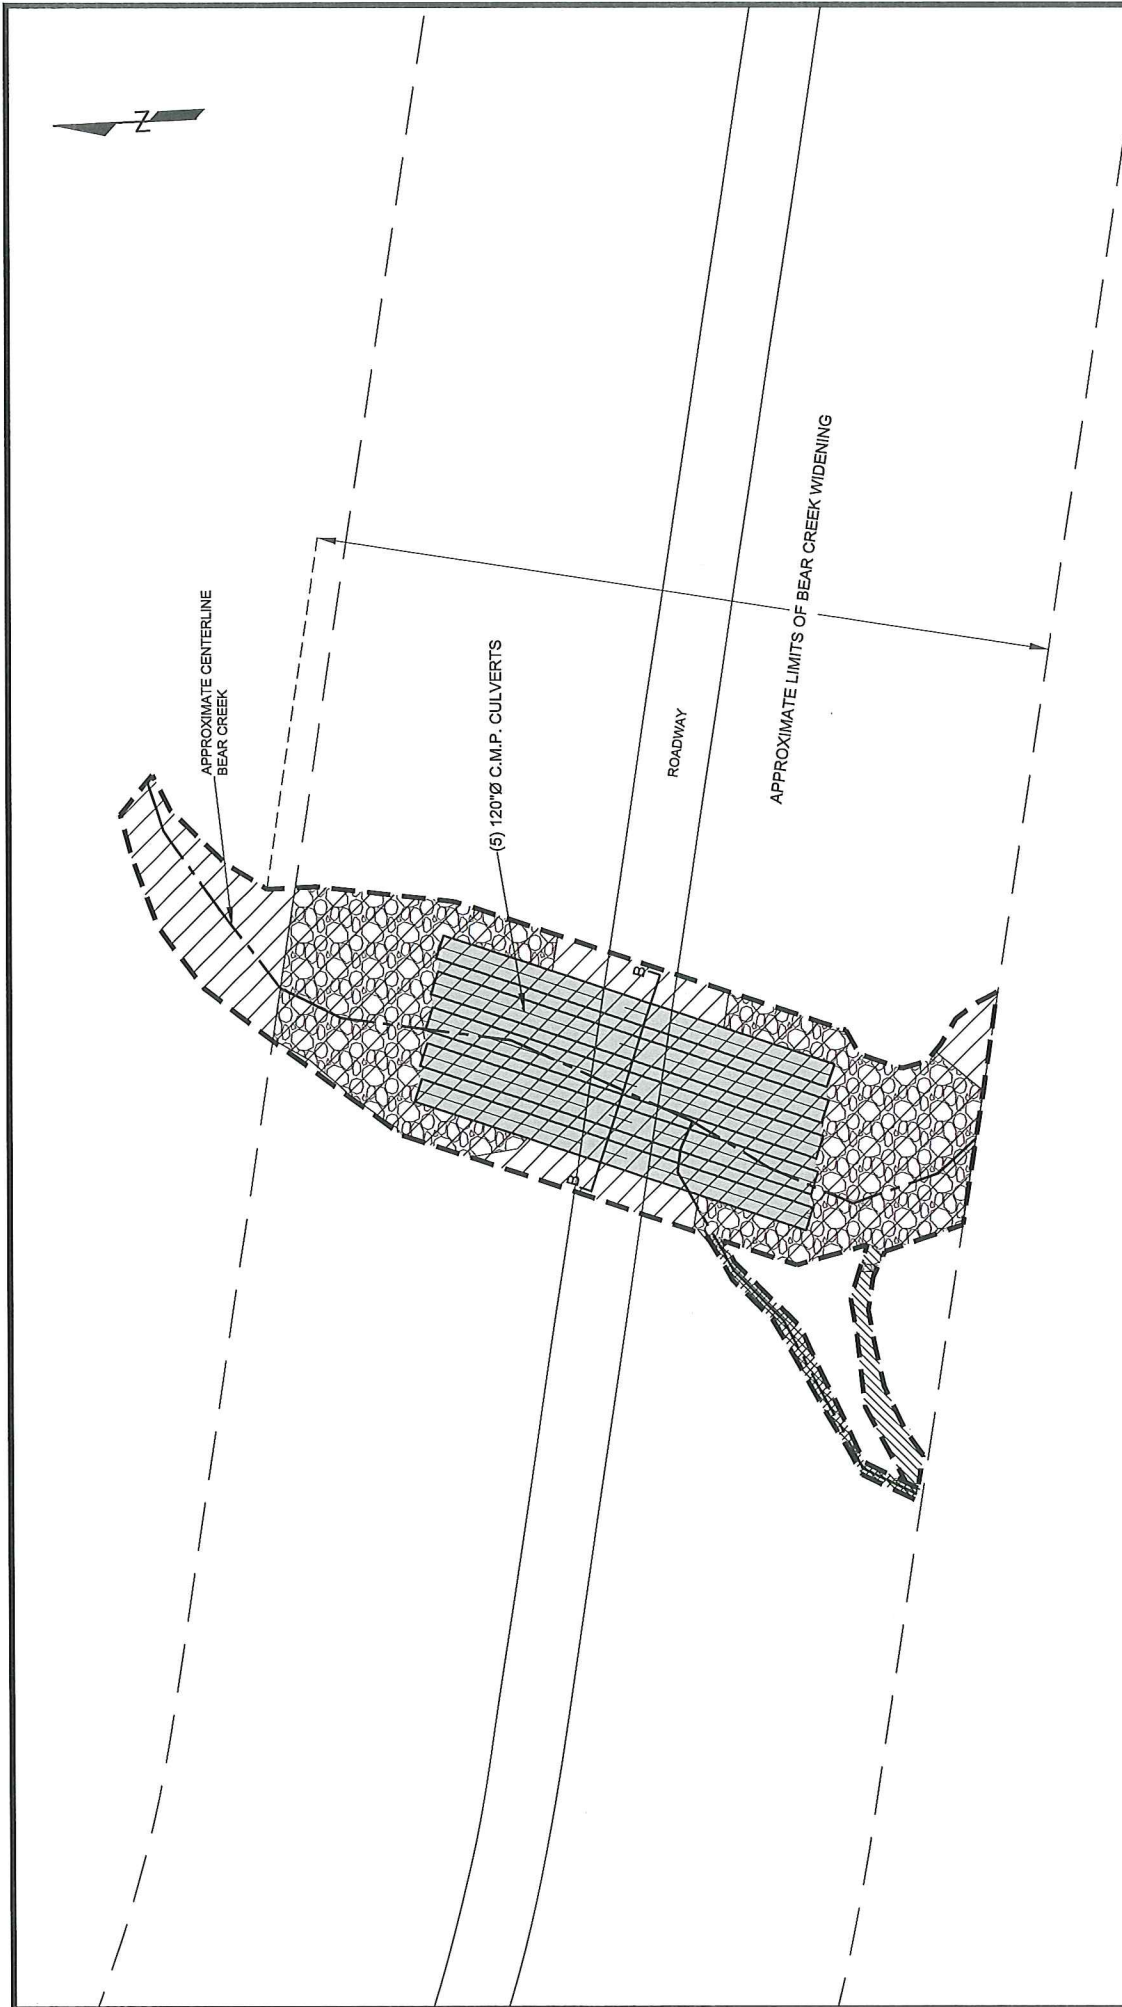

Corrigan OSB, L.L.C.
Corrigan, Texas

Department of the Army Permitting

Detail B Plan View

Polk County

Drawn: CPUACAD
Checked: WLB
Approved: TEW
Date: 08/17/2016
Dwg. No.: A12356-47

Figure 3

CK ASSOCIATES
Engineering & Construction

LEGEND

--- APPROXIMATE CENTERLINE PRECONSTRUCTION

--- APPROXIMATE LIMITS OF IMPACT

EPHEMERAL FILLED (141 LF; 0.02 ACRES)

EPHEMERAL REROUTE (101 LF; 0.02 ACRES)

MECHANIZED LAND CLEARING AND FILL DEPOSITION (0.78 ACRES)



RIP-RAP (0.46 ACRES)

LIMITS OF CULVERTS (APPROX. 174')

0' 80' 160'

SCALE: 1" = 80'

Limits of Impact determined from field GPS data prior to construction, recent aerial photos, and construction drawings provided by Johnson & Pace Inc.

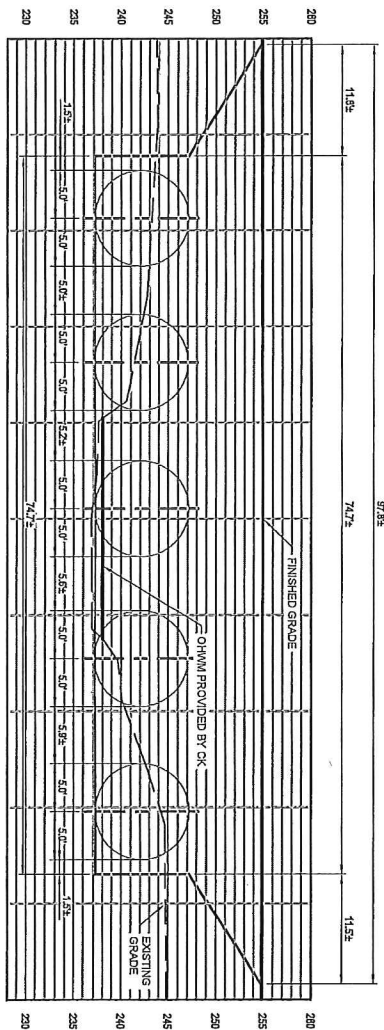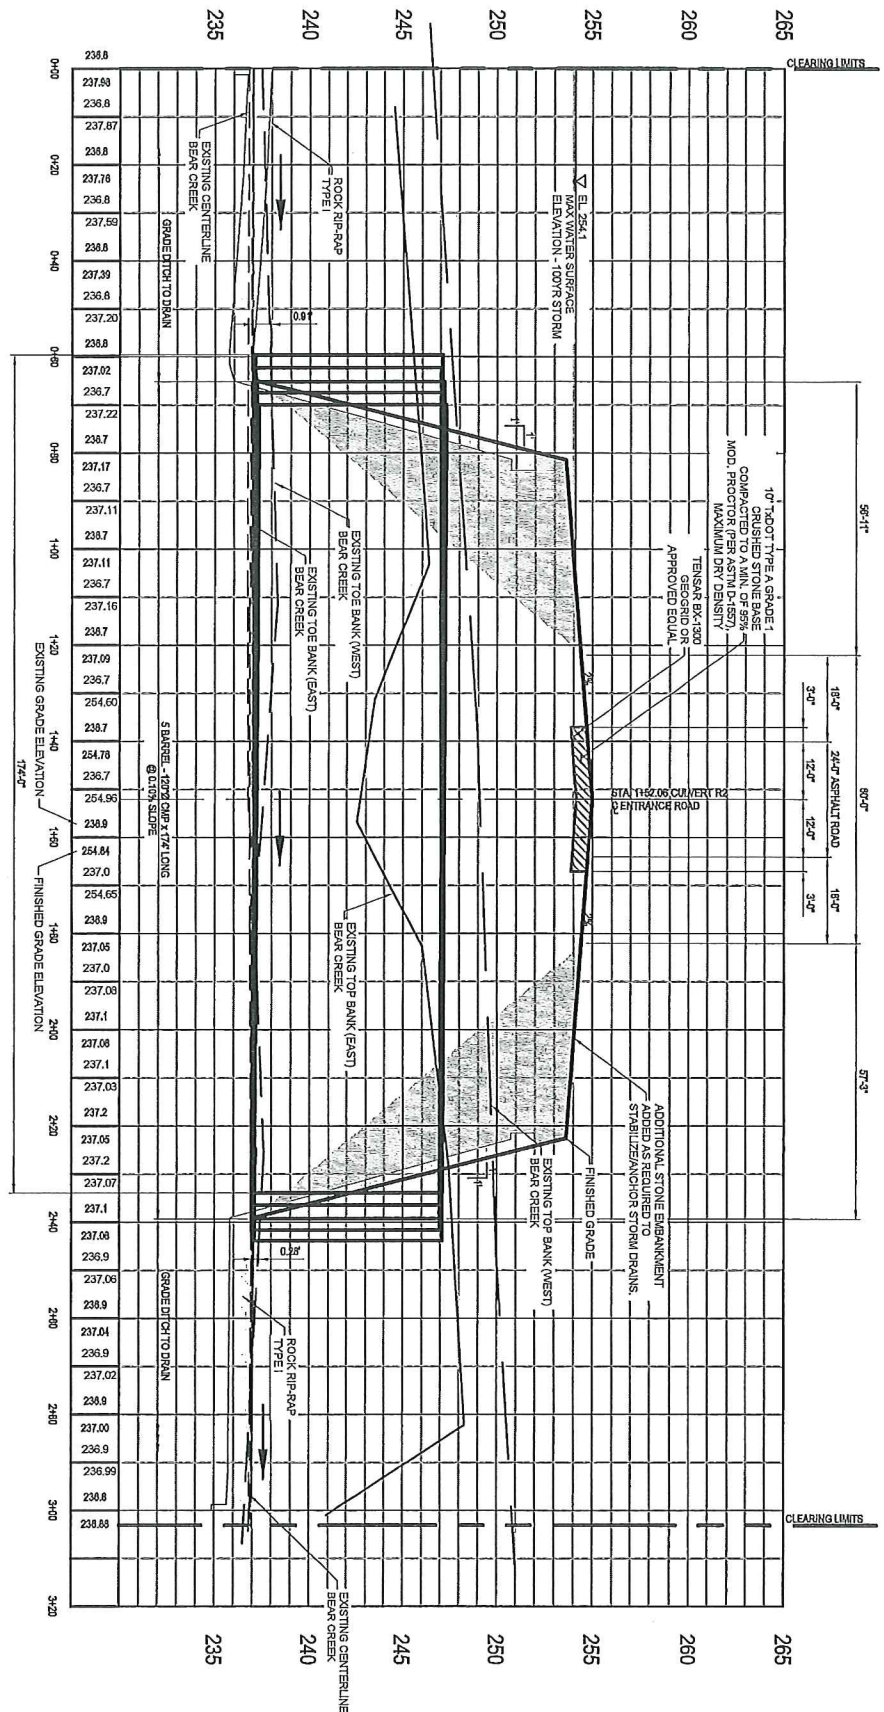

CULVERTS WERE INSTALLED WITH THE CULVERT FLOWLINE AT OR BELOW THE EXISTING CREEK FLOWLINE. THE AREA BENEATH EACH CULVERT WAS REMODELED AND COMPACTED (AS REQUIRED) TO ENSURE GOOD PIPE BEDDING, AS THE EXISTING ROCK BASE IN THE CREEK WOULD ALLOW.

SECTION B-B

SCALE: 1"=20'

PROFILE AND SECTION B-B FROM AS-BUILT
CULVERT DRAWINGS T10135-50 AND T10135-51

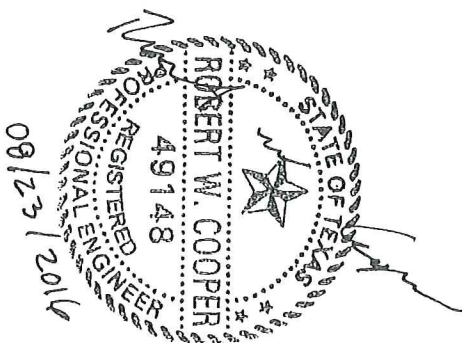


FIGURE 4

OSB-3

DRAWN BY: ACA	DATE: 08/23/16	JOB NO.: 2225-122
SHEET NO.:		REVISION NO: 0



**JOHNSON
& PACE
INCORPORATED**

ENGINEERING • ARCHITECTURE • SURVEYING
1201 NW LOOP 281, SUITE 100, LONGVIEW,
TEXAS 75604
(903)763-0663 FAX (903)763-8803
website: www.johnsonpace.com
TBPE F-4691

AUG 24 2016